

- LEGEND**
- RIGHT-OF-WAY
 - - - RIGHT-OF-WAY TO BE VACATED
 - - - PARK BOUNDARY

PROJECT: M3-P004
DESCRIPTION: MAPS 3 M3-P004 UPPER DOWNTOWN PARK
COMPLETION: JANUARY 25, 2017
AS-BUILT: JUNE 1, 2017
ENGINEER: JOHNSON & ASSOCIATES, INC.
CONTRACTOR: MATTHEWS TRENCHING CO., INC.

EXISTING PLAT AND RIGHT-OF-WAY WITHIN PARK BOUNDARY TO BE CLOSED AND VACATED BY MAPS 3 UPPER DOWNTOWN PARK PROJECT M3-P004

NOTE:
 ALL CLEAN EXCAVATED MATERIAL PRODUCED FROM SANITARY SEWER LINE, WATER LINE AND STORM SEWER INSTALLATION SHALL BE DISPOSED OF WITHIN THE LIMITS OF THE FUTURE PARK BOUNDARY. REFER TO SHEET 1.8

Copyright © 2017 Johnson & Associates, Inc.

NO.	REVISIONS DESCRIPTION	DATE

Johnson & Associates, Inc.
 1 E. Sheridan Ave., Suite 200
 Oklahoma City, OK 73104
 (405) 235-8075 FAX (405) 235-8078
Certificate of Authorization #1484 Exp. Date 06-30-2017
 ENGINEERS SURVEYORS PLANNERS



JOHNSON & ASSOCIATES

MAPS 3 PROJECT NO. M3-P004
UPPER DOWNTOWN PARK
 OKLAHOMA CITY, OKLAHOMA COUNTY, OKLAHOMA
STORM SEWER GENERAL LAYOUT

Proj. No.: M3-P004 Date: 09-16-15 Scale: 1"=100'	Checked By: _____ Approved By: _____
--	---

5.0


SHEET NUMBER

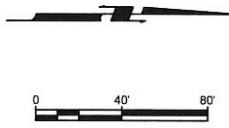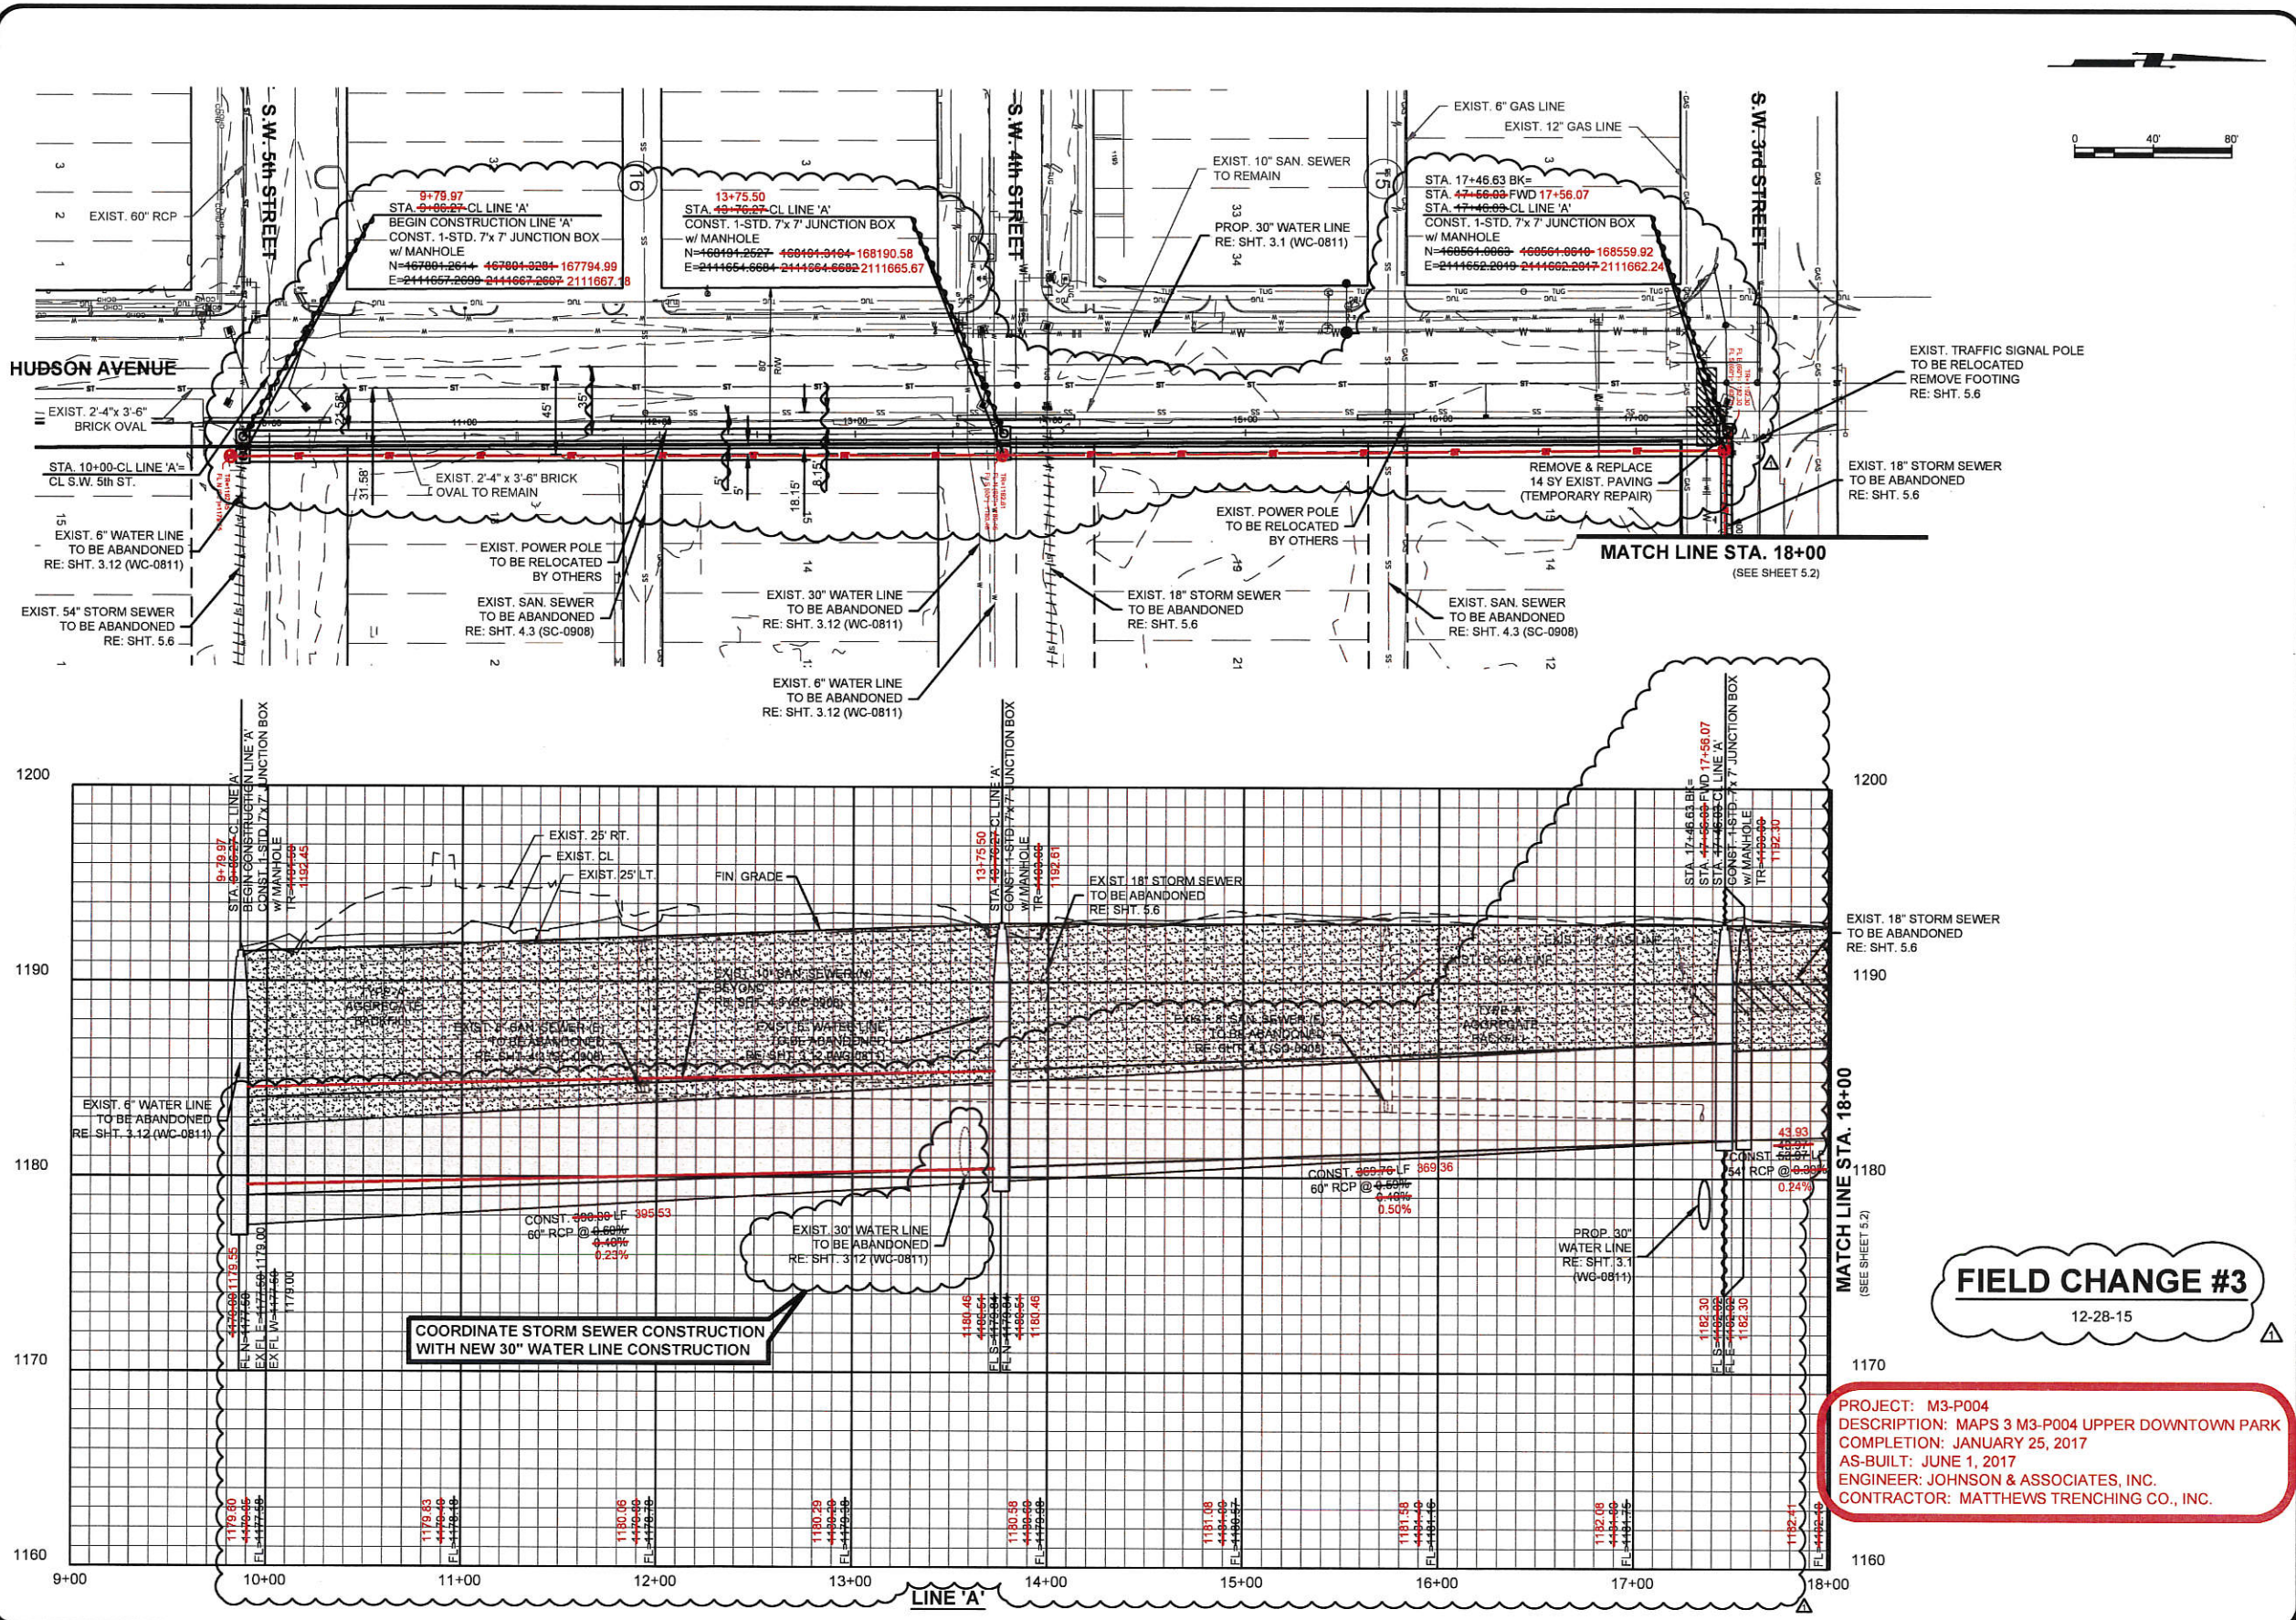

FIELD CHANGE #3
12-28-15

PROJECT: M3-P004
DESCRIPTION: MAPS 3 M3-P004 UPPER DOWNTOWN PARK
COMPLETION: JANUARY 25, 2017
AS-BUILT: JUNE 1, 2017
ENGINEER: JOHNSON & ASSOCIATES, INC.
CONTRACTOR: MATTHEWS TRENCHING CO., INC.

NO.	REVISIONS	DESCRIPTION	DATE
1	A	FIELD CHANGE #3	12-28-15

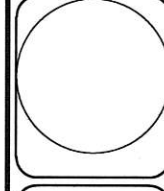


Johnson & Associates, Inc.
1 E. Sheridan Ave., Suite 200
Oklahoma City, OK 73104
(405) 235-8075 FAX (405) 235-8078
Certificate of Authorization #1484 Exp. Date 06-30-2017
ENGINEERS SURVEYORS PLANNERS




MAPS 3 PROJECT NO. M3-P004
UPPER DOWNTOWN PARK
OKLAHOMA CITY, OKLAHOMA COUNTY, OKLAHOMA
STORM SEWER
PLAN & PROFILE - LINE 'A'

Proj. No. M3-P004
Date 08-18-15
Scale (Horiz.) 1"=40'
(Vert.) 1"=8'
Checked By: _____
Approved By: _____

SHEET NUMBER
5.1

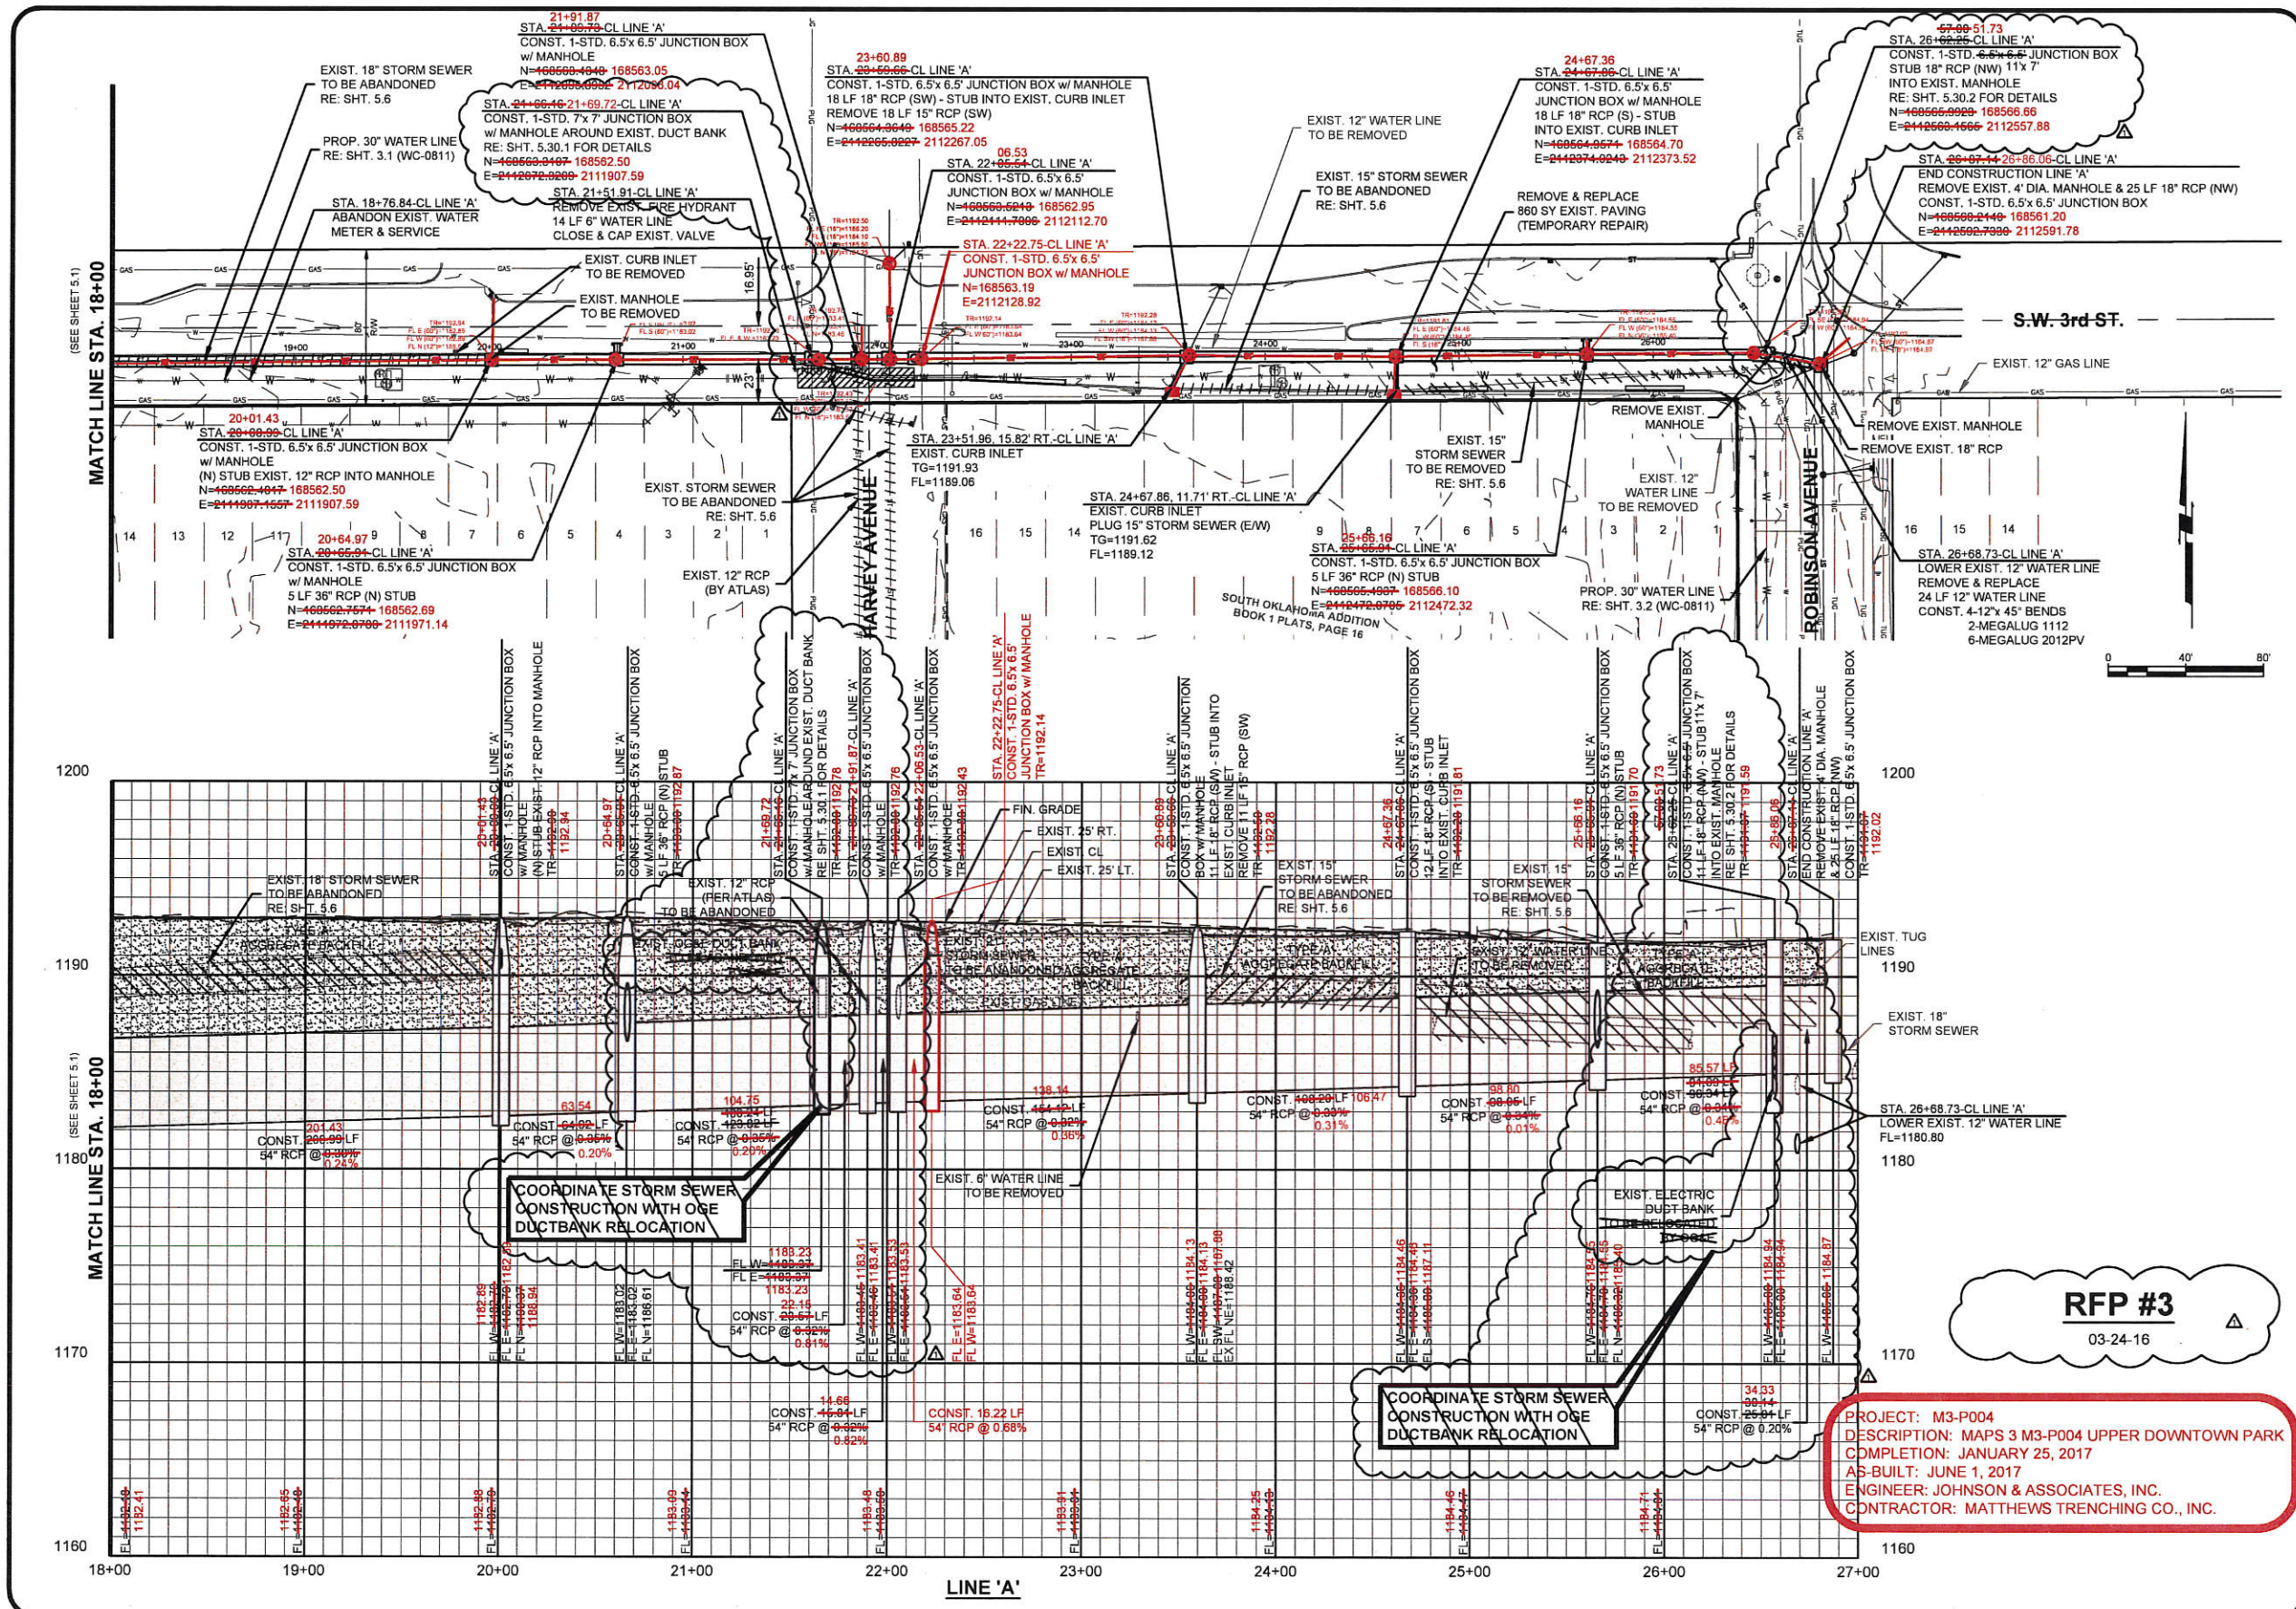

NO.	DESCRIPTION	DATE
1	FIELD CHANGE #5	03-24-16

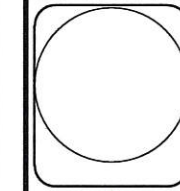

Johnson & Associates, Inc.
 1 E. Sheridan Ave., Suite 200
 Oklahoma City, OK 73104
 (405) 235-5075 FAX (405) 235-9078
 Certificate of Authorization #1684 Exp. Date 06-30-2017
 ENGINEERS SURVEYORS PLANNERS





MAPS 3 PROJECT NO. M3-P004
 UPPER DOWNTOWN PARK
 OKLAHOMA CITY, OKLAHOMA COUNTY, OKLAHOMA
 STORM SEWER
 PLAN & PROFILE - LINE 'A'

RFP #3
 03-24-16

PROJECT: M3-P004
 DESCRIPTION: MAPS 3 M3-P004 UPPER DOWNTOWN PARK
 COMPLETION: JANUARY 25, 2017
 AS-BUILT: JUNE 1, 2017
 ENGINEER: JOHNSON & ASSOCIATES, INC.
 CONTRACTOR: MATTHEWS TRENCHING CO., INC.

Proj. No.: M3-P004
 Date: 03-16-15
 Scale: (Horiz) 1"=40'
 (Vert) 1"=4'
 Checked By: _____
 Approved By: _____


SHEET NUMBER
5.2

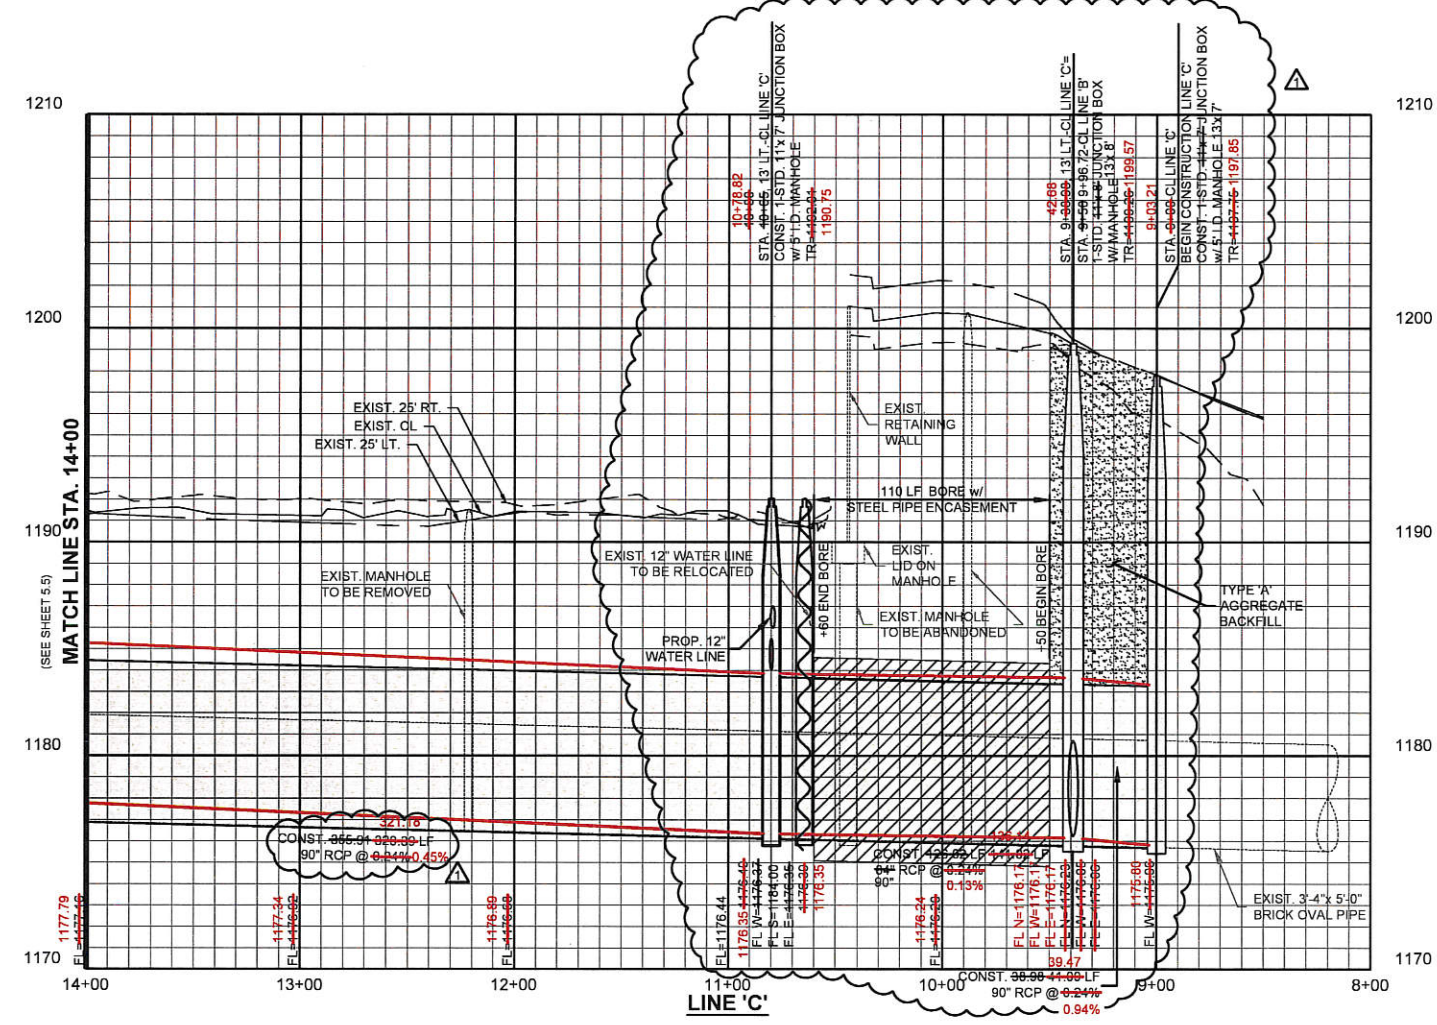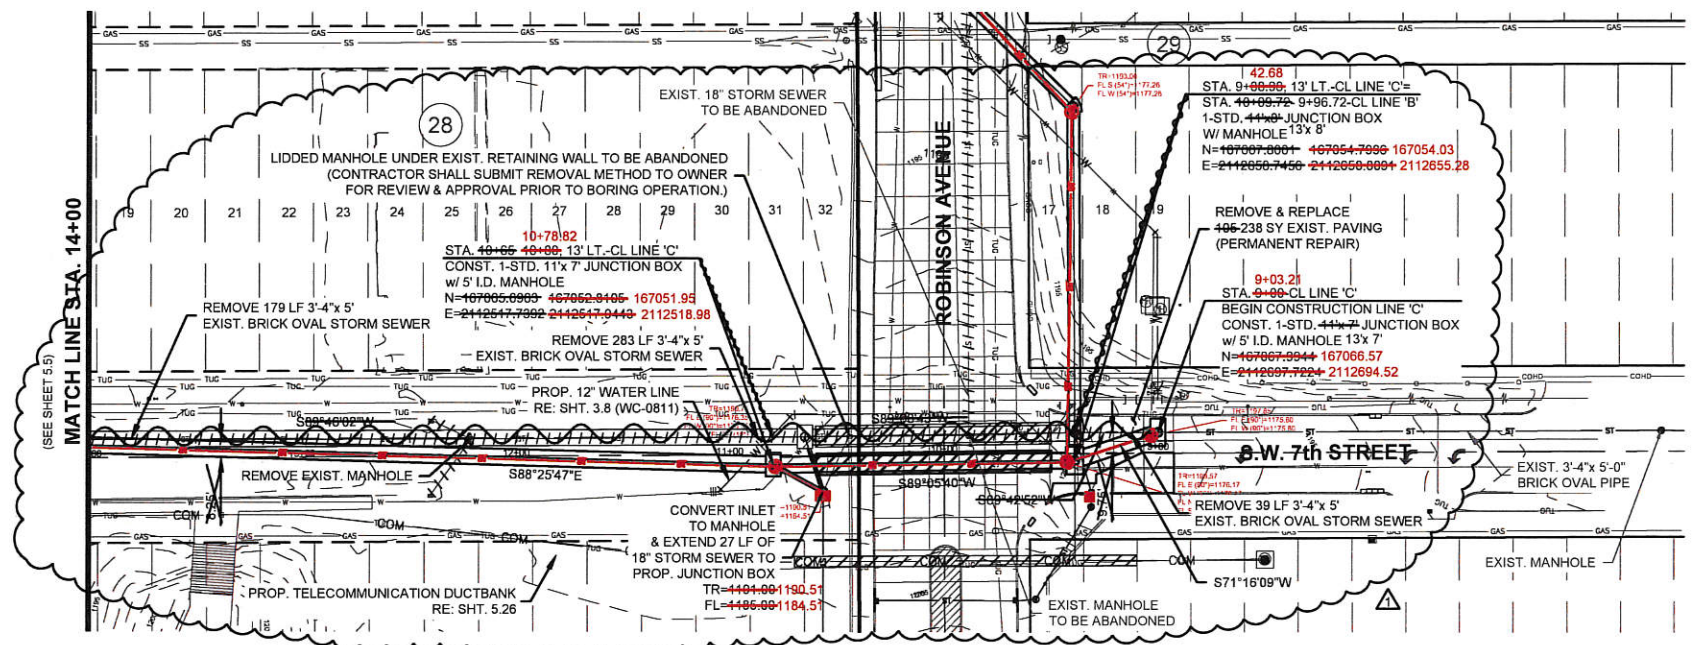

PROJECT: M3-P004
 DESCRIPTION: MAPS 3 M3-P004 UPPER DOWNTOWN PARK
 COMPLETION: JANUARY 25, 2017
 AS-BUILT: JUNE 1, 2017
 ENGINEER: JOHNSON & ASSOCIATES, INC.
 CONTRACTOR: MATTHEWS TRENCHING CO., INC.

FIELD CHANGE #1
 12-10-15

NO.	REVISIONS DESCRIPTION	DATE
1	FIELD CHANGE #1	12-10-15

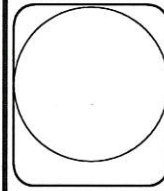



Johnson & Associates, Inc.
 1 E. Sheridan Ave., Suite 200
 Oklahoma City, OK 73104
 (405) 235-6075 FAX (405) 235-6078
 Certificate of Authorization # 164. Exp. Date: 05-30-2017
 ENGINEERS SURVEYORS PLANNERS



MAPS 3 PROJECT NO. M3-P004
 UPPER DOWNTOWN PARK
 OKLAHOMA CITY, OKLAHOMA COUNTY, OKLAHOMA
 STORM SEWER
 PLAN & PROFILE - LINE 'C'

Proj No.: M3-P004
 Date: 09-15-15
 Scale (Horiz.): 1"=40'
 (Vert): 1"=4'
 Checked By: _____
 Approved By: _____

SHEET NUMBER
5.4

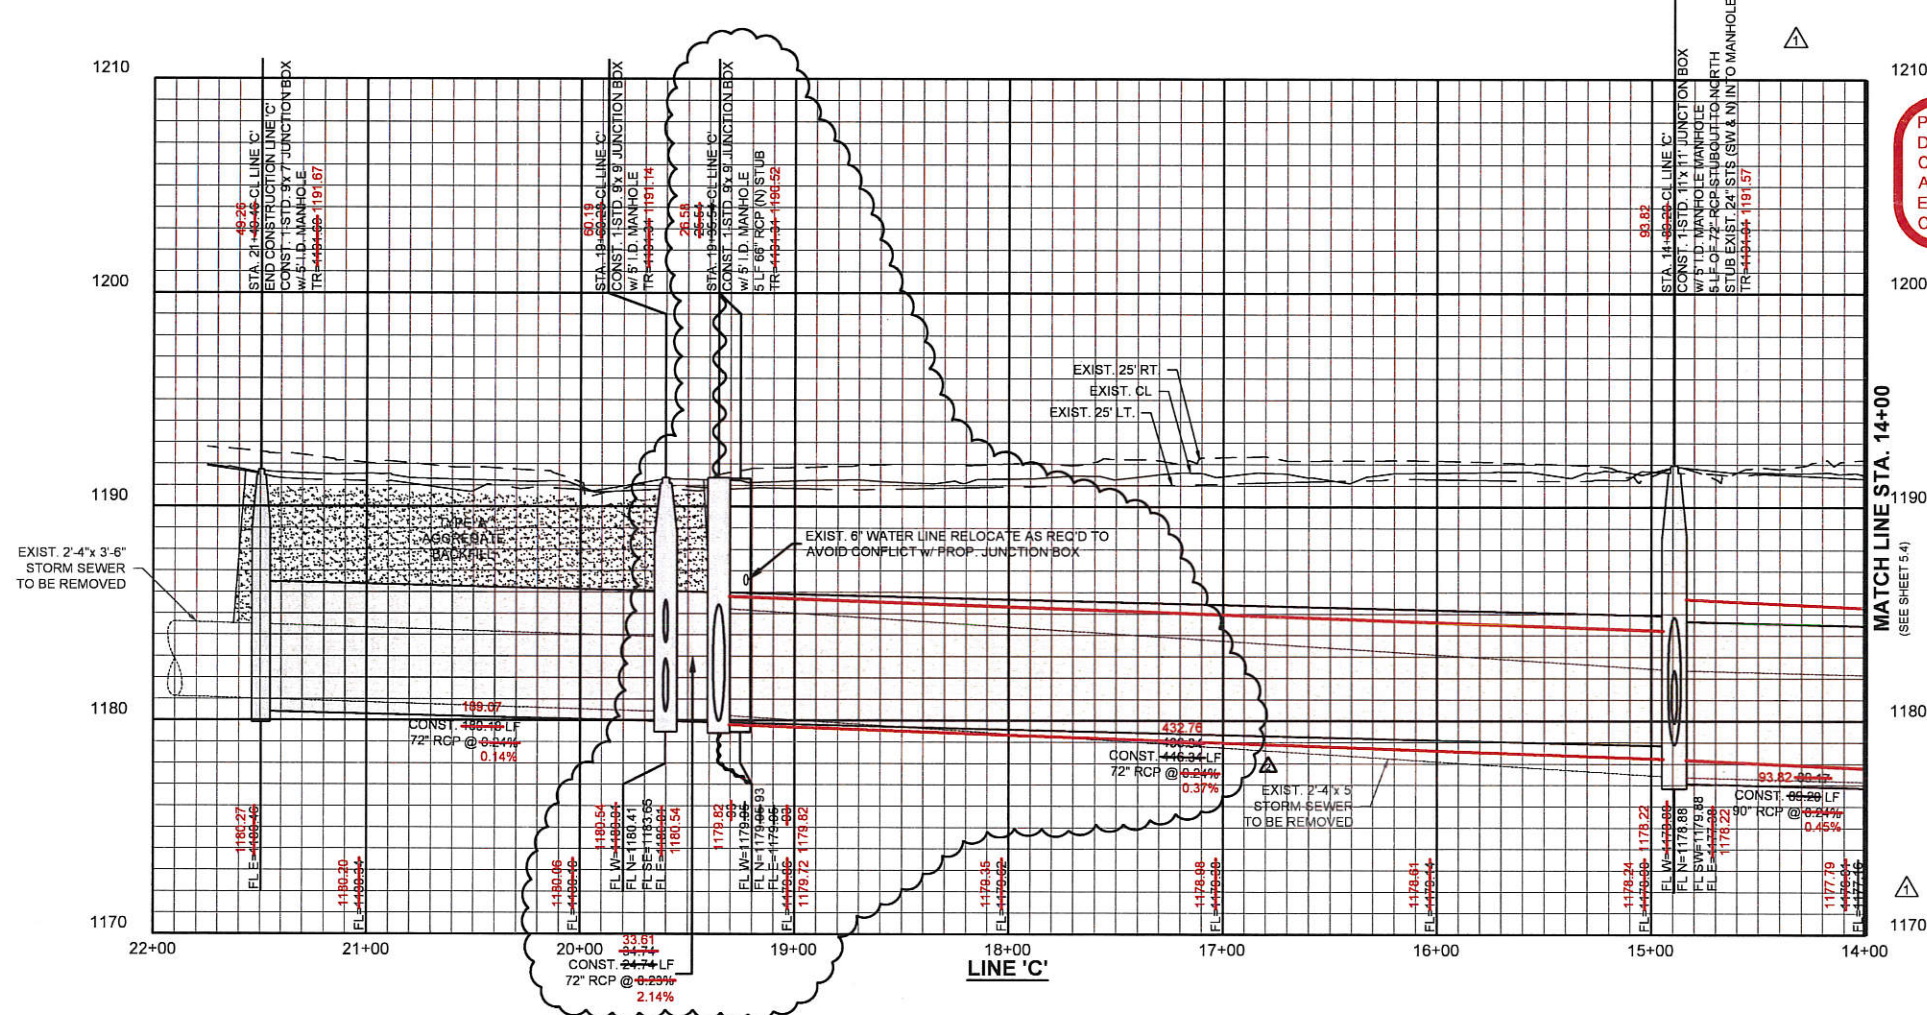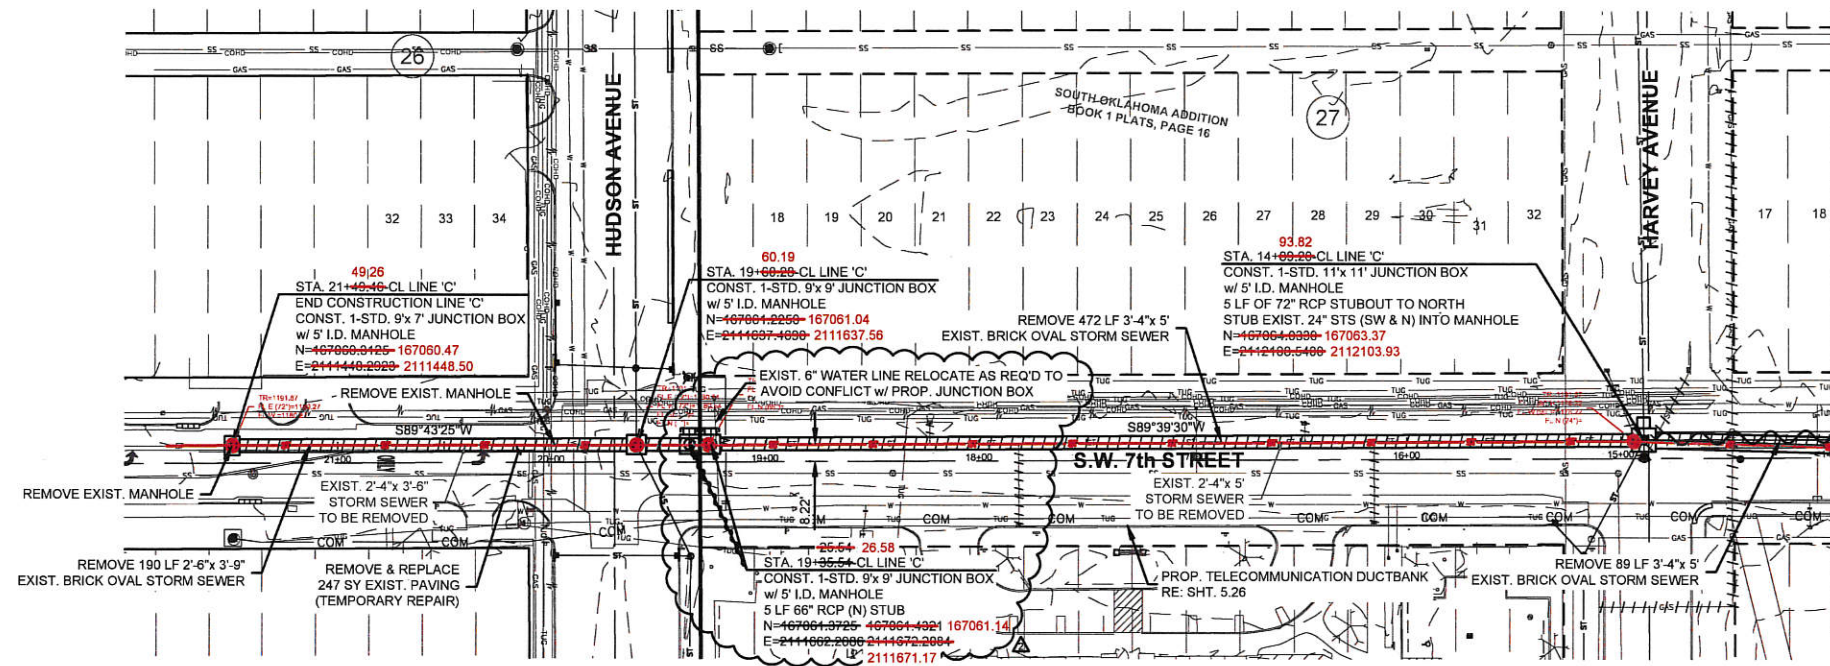

PROJECT: M3-P004
 DESCRIPTION: MAPS 3 M3-P004 UPPER DOWNTOWN PARK
 COMPLETION: JANUARY 25, 2017
 AS-BUILT: JUNE 1, 2017
 ENGINEER: JOHNSON & ASSOCIATES, INC.
 CONTRACTOR: MATTHEWS TRENCHING CO., INC.

FIELD CHANGE #3
 12-28-15

FIELD CHANGE #1
 12-10-15

Copyright © 2017 Johnson & Associates, Inc.

NO.	REVISIONS	DESCRIPTION	DATE
1	FIELD CHANGE #1		12-05-15
2	FIELD CHANGE #3		12-28-15

Johnson & Associates, Inc.
 1 E. Sheridan Ave., Suite 200
 Oklahoma City, OK 73104
 (405) 233-8075 FAX (405) 235-8078
 Certificate of Authorization #184 Exp. Date 06-30-2017
 ENGINEERS SURVEYORS PLANNERS

MAPS 3 PROJECT NO. M3-P004
 UPPER DOWNTOWN PARK
 OKLAHOMA CITY, OKLAHOMA COUNTY, OKLAHOMA

STORM SEWER
 PLAN & PROFILE - LINE 'C'

Proj. No.: M3-P004
 Date: 09-16-15
 Scale: (Horiz) 1"=40'
 (Vert) 1"=4'
 Checked By: _____
 Approved By: _____

SHEET NUMBER
5.5